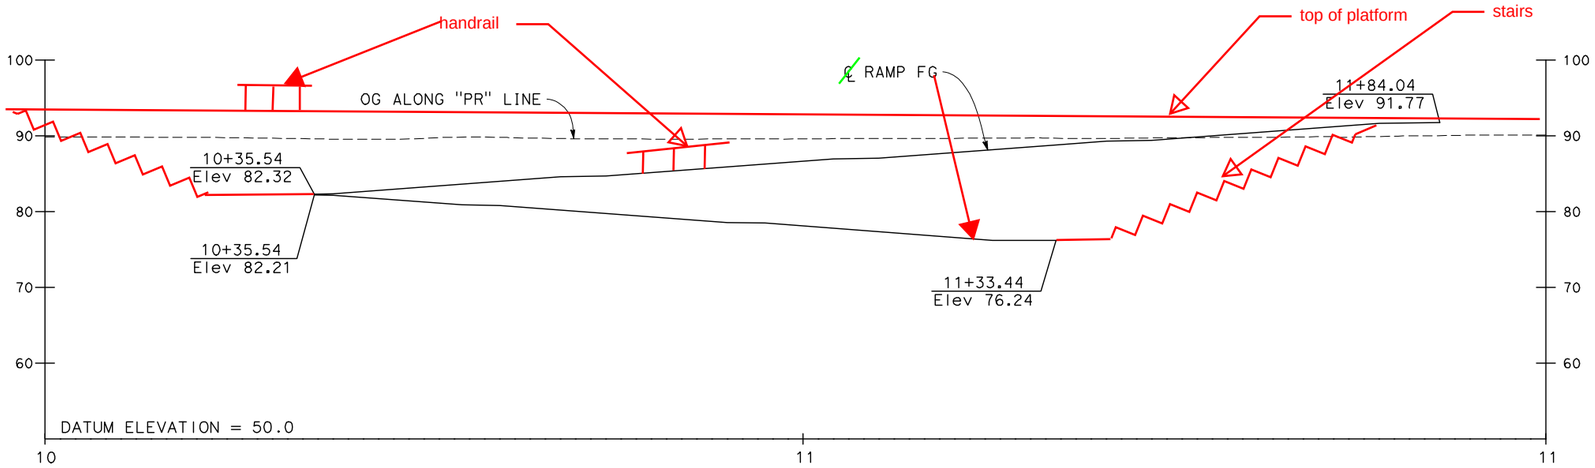

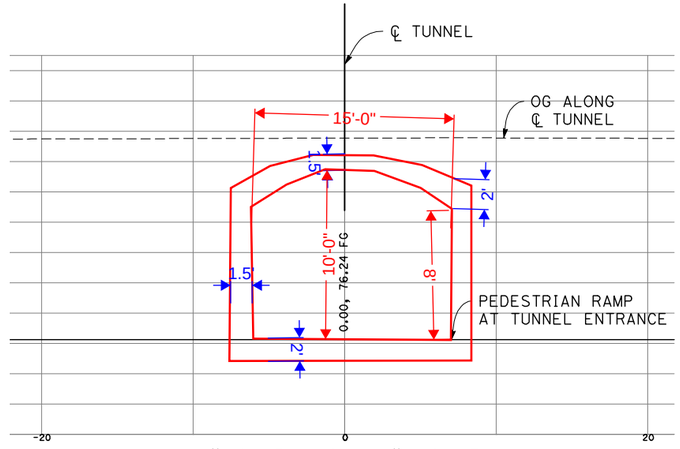

"8ft Ped Curve" 10+25

~~TUNNEL TYPICAL~~ SECTION A-A

1" = 5'

ELEVATION

1" = 20'

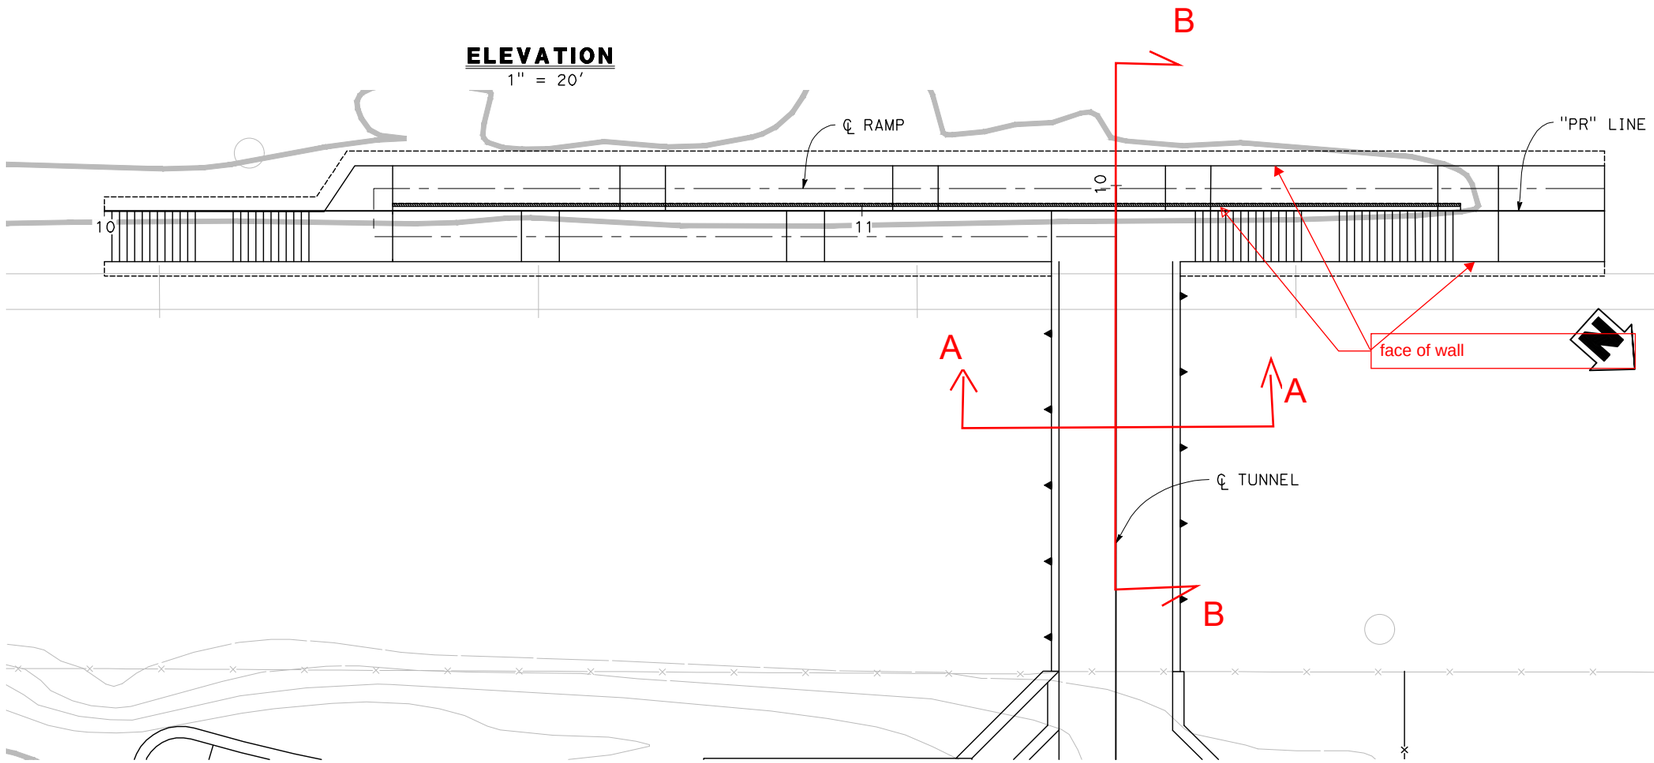

PLAN

1" = 20'

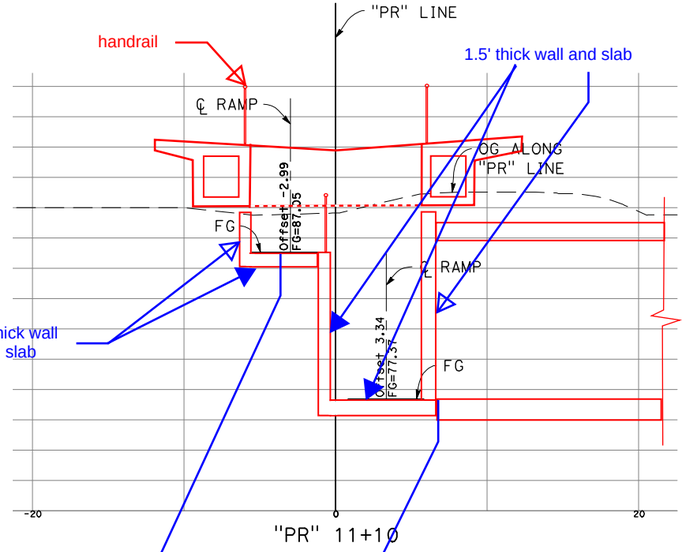

"PR" 11+10

~~TYPICAL~~ SECTION B-B

1" = 5'

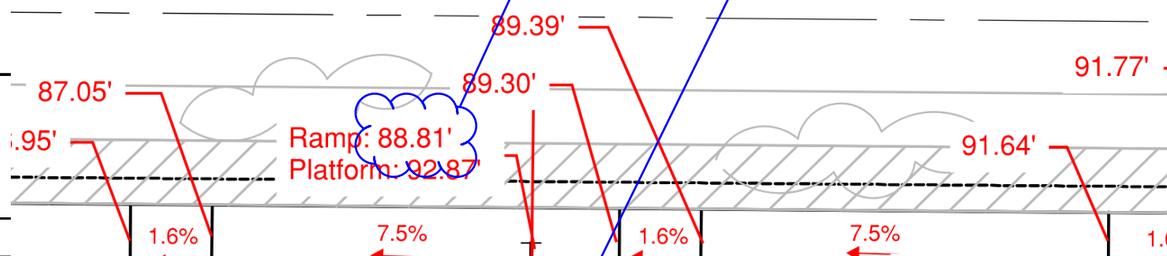

REV. #	BY	DATE	DESCRIPTION